


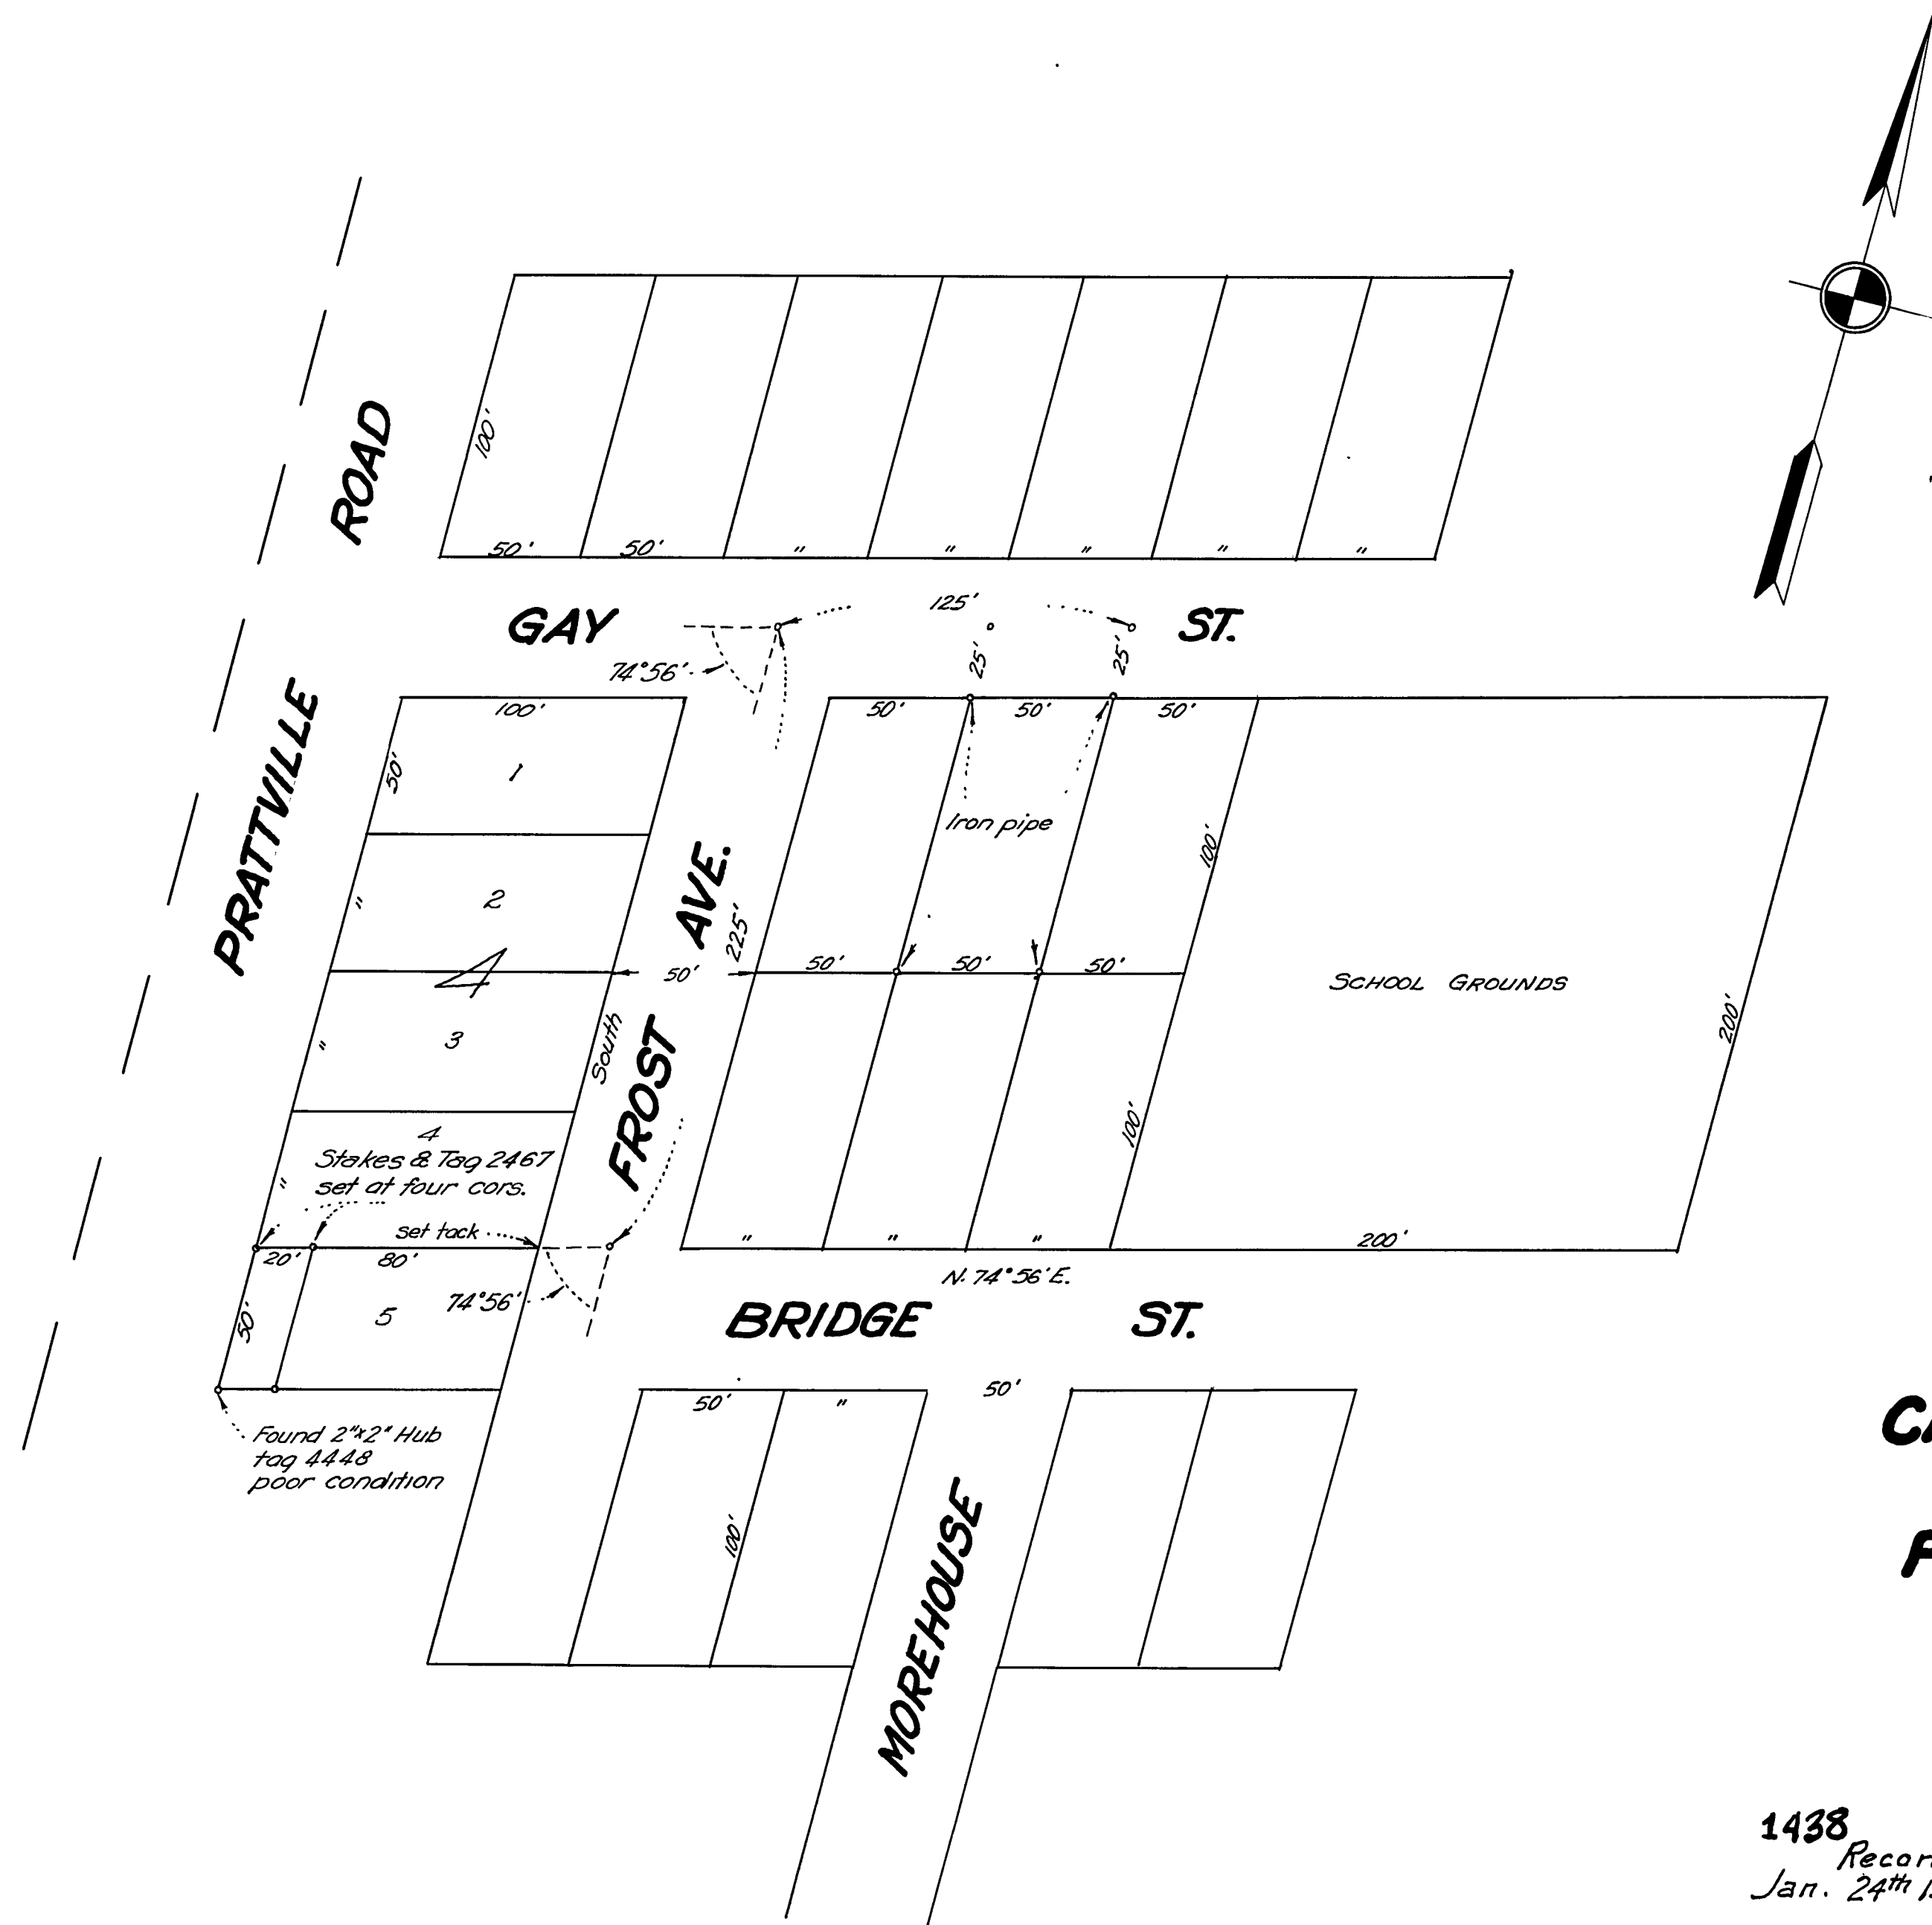

Certificate of Surveyor

I, L. A. Scanland, do hereby certify that I am a
licensed Land Surveyor of the state of
California; that this map correctly represents
a survey made by me on the 5th day of
Sept. 1949 and that all monuments shown
hereon actually exist and occupy the
positions indicated

Lloyd A. Scanland License No. 2467

Approved *A. J. Watson* 1/24/50
County Surveyor

**RECORD SURVEY
CALIFORNIA PACIFIC UTILITIES CO.
OF
PORTION LOT NO. 5 BLOCK NO. 4
CHESTER, CALIFORNIA**

SEPTEMBER 20, 1949 SURVEYED BY L. A. S.
SCALE: 1 INCH = 50' DRAWN BY J. R. U.

1438
Recorded at the request of A. J. Watson
Jan. 24th 1950 at 30 minutes past 9 A.M.
W. L. Rogers
Recorder of Plumas County